

DRAWING NUMBER
A-165
Cantor Fitzgerald
105P E-6

DRAWING NUMBER
A-165
Cantor Fitzgerald
105P E-6

DRAWING NUMBER
A-165
Cantor Fitzgerald
105P E-6

DRAWING NUMBER
A-165
Cantor Fitzgerald
105P E-6



IF THIS DRAWING IS NOT 24" X 36" IT IS
A REDUCED PRINT SCALE ACCORDINGLY

JUSTIN PC
ARCHITECTS
200 EXINGTON AVE
NEW YORK, NY 10001
TEL 606 600 8800

JOHN C. WESTRICK & ASSOCIATES
CONSULTING ENGINEERS
210 MAPLE AVE. SOUTH PLAINFIELD, N.J.
07080 601 861-4170

DATE	ISSUED TO	PR.	TR.
1/25/91	PORT AUTHORITY E&C APPROVAL	12	1
1/25/91	CEC FOR RECORD CONTRACTS FOR BIDDING	9	4
5/19/91	P.A. FOR APPROVAL	10	1
6/19/91	PORT AUTHORITY	10	1
9-21-91	P.A. AS BUILT DRAWING	11	1

JOHN C. WESTRICK & ASSOCIATES
CONSULTING ENGINEERS
210 MAPLE AVENUE
SOUTH PLAINFIELD, N.J. 07080
601-6170

AS BUILT DRAWINGS
Signature _____ Date _____

2	8-6-91	AS PER AS-BUILT CONDITIONS	RE
1	4-29-91	AS PER P.A. COMMENTS	RE
NO	DATE	REVISION	BY

CANTOR, FITZGERALD SECURITIES CORP.
105th FLOOR
ONE WORLD TRADE CENTER, NEW YORK, N.Y.


PROPOSED NEW TRADING ROOM FOR INVESTMENT STRATEGIES
SMOKE DETECTION PLAN
PROJECT NO. 91113
SCALE 1/4" = 1'-0"
DRAWN BY GCD
CHECKED BY JCW
DATE 3-20-91

DRAWING NO.
105P E-6

LEGEND (FOR THIS DRAWING ONLY)

- (E) EXISTING SMOKE DETECTOR - CEILING MOUNTED
- (E_{UF}) EXISTING SMOKE DETECTOR - MOUNTED UNDER RAISED FLOOR
- E — EXISTING SMOKE DETECTION WIRING
- (N) SMOKE DETECTOR - CEILING MOUNTED
- (N_{UF}) SMOKE DETECTOR - MOUNTED UNDER RAISED FLOOR
- S — SMOKE DETECTION WIRING RUN ABOVE HUNG CEILING
- S --- SMOKE DETECTION WIRING RUN BELOW RAISED FLOOR

NOTE
FOR SPECIFICATIONS SEE DWG. E-2

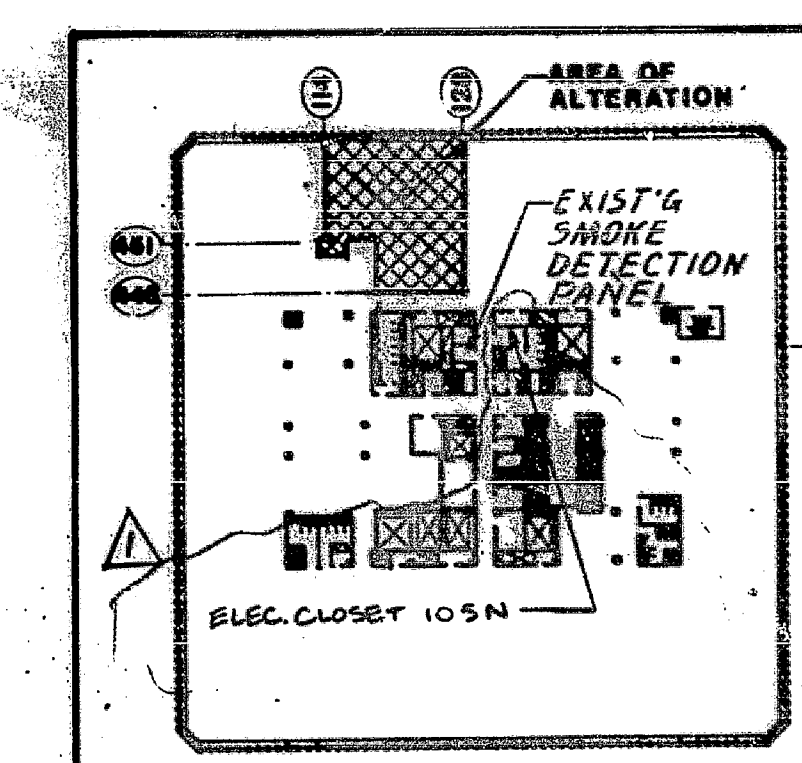

KEY PLAN
1/8" = 1'-0"

PHASE
P
TAA NO.

